THIS DRAWING IS UNPUBLISHED. DIFFUSION RESEINTE AMP
RELEASED FOR PUBLICATION ,19 .
© COPYRIGHT 1997 BY AMP INCORPORATED. ALL RIGHTS RESERVED TOUS DROITS RESERVES

LOC	DIST
FH	2

REVISIONS

P	LTR REV	DESCRIPTION MODIFICATIONS	DATE	DWN DESS.	APVD APP.
	B	EQ00-0429-01	18-Oct-01	EN	HV

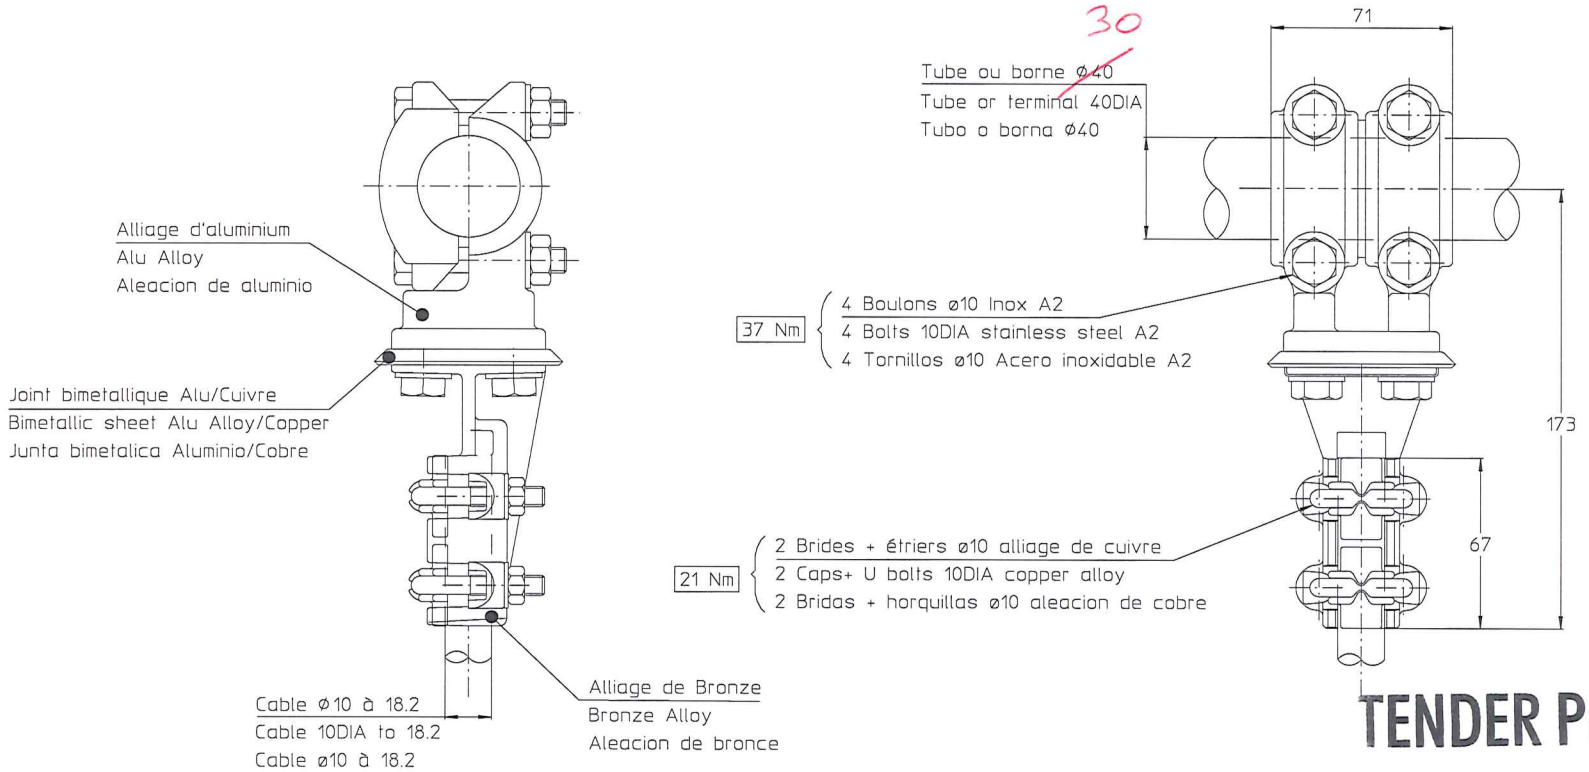

57.5.01.0027

TENDER PURPOSE ONLY

THIS DRAWING IS A CONTROLLED DOCUMENT FOR AMP INCORPORATED. IT IS SUBJECT TO CHANGE AND THE CONTROLLING ENGINEERING ORGANIZATION SHOULD BE CONTACTED FOR THE LATEST REVISION. CE PLAN EST UN DOCUMENT CONTROLE PAR AMP INCORPORATED IL EST SUSCEPTIBLE D'ETRE REVISE. CONTACTER LE SERVICE TECHNIQUE D'AMP SIMEL POUR OBTENIR LA DERNIERE REVISION.

DIMENSIONS: mm

TOLERANCES UNLESS OTHERWISE SPECIFIED PER TOLERANCES NON SPECIFIEES SELON : -

MATERIAL MATIERE -

FINISH FINITION -

DWN/DESSINE NIVOIS 18-Oct-01
CHK/VERIFIE ROYER 18-Oct-01
APVD/APPROUVE VIAL -
PRODUCT SPEC SPEC. PRODUIT 02BFH0033
APPLICATION SPEC SPEC. APPLICATION -
WEIGHT MASSE APPROX. 1.7 KG

AMP — AMP-SIMEL, 21220 Gevrey Chambertin, FRANCE

NAME TITRE S 966 ~~40~~B 18 30

SIZE FORMAT A3 | CAGE CODE 00779 | DRAWING NO No PLAN ~~C-1574214~~

CUSTOMER DWG / PLAN CLIENT — UNIQUEMENT POUR REFERANCE | SCALE ECHELLE 1/2 | SHEET FEUILLE 1 OF DE 1 | REV B

ITEM: 5

AMP 1470-19 REV 09MAY94